

STATE ENGINEER
Salem, Oregon

Linn 4224
LINN 4224
Well Record

STATE WELL NO. 10/2W-20N
COUNTY LINN
APPLICATION NO. GR-2448

OWNER: L. W. Faulkner


MAILING ADDRESS: 210 Fulton Street

LOCATION OF WELL: Owner's No.

CITY AND STATE: Albany, Oregon

SW 1/4 SW 1/4 Sec. 20 T. 10 S, R. 2 W., W.M.

Bearing and distance from section or subdivision corner 924' N. and 528' E.

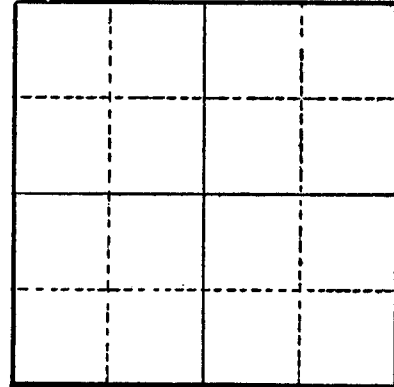

Section

Altitude at well

TYPE OF WELL: Drilled Date Constructed 1950

Depth drilled 20 Depth cased 20

CASING RECORD:

8-inch

FINISH:

Slot perforations from 14 to 20

AQUIFERS:

WATER LEVEL:

10-feet

PUMPING EQUIPMENT: Type Fairbanks Morse Centrifugal H.P. 15
Capacity 300 G.P.M.

WELL TESTS:

Drawdown ft. after hours G.P.M.
Drawdown ft. after hours G.P.M.

USE OF WATER Irrigation Temp. °F. 19

SOURCE OF INFORMATION GR-2320

DRILLER or DIGGER Marion West, Salem, Oregon

ADDITIONAL DATA:

Log Water Level Measurements Chemical Analysis Aquifer Test

REMARKS: