

STATE ENGINEER
Salem, Oregon

Linn 4225
LINN 4225
Well Record

STATE WELL NO. 10/2W-20Q
COUNTY Linn
APPLICATION NO. GR-3741

OWNER: Harvey Mitchell


MAILING ADDRESS: Route 1

LOCATION OF WELL: Owner's No. 7

CITY AND STATE: Jefferson, Oregon

SW 1/4 SE 1/4 Sec. 20 T. 10 N. S, R. 2 E. W., W.M.

Bearing and distance from section or subdivision corner 955 1/2 feet North 10° East of S 1/4 Corner, Section 20.

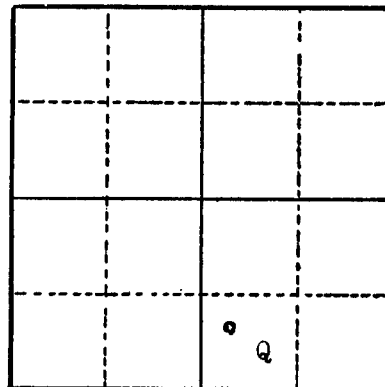

Section 20

Altitude at well 226 feet

TYPE OF WELL: Drilled Date Constructed 1954

Depth drilled 25 feet Depth cased

CASING RECORD:

10 inch

FINISH:

AQUIFERS:

WATER LEVEL:

7 feet

PUMPING EQUIPMENT: Type Fairbanks Morse H.P.

Capacity G.P.M.

WELL TESTS:

Drawdown 2 ft. after 600 hours G.P.M.

Drawdown ft. after hours G.P.M.

USE OF WATER Irrigation Temp. °F., 19

SOURCE OF INFORMATION GR-4148

DRILLER or DIGGER Bill Hamilton, Albany

ADDITIONAL DATA:

Log (NA) Water Level Measurements Chemical Analysis Aquifer Test

REMARKS: