

STATE ENGINEER  
Salem, Oregon

Linn  
H 226

# Well Record

STATE WELL NO. 10/2W-20P  
COUNTY Linn  
APPLICATION NO. GR-3744

OWNER: Harvey Mitchell


MAILING ADDRESS: Route 1

LOCATION OF WELL: Owner's No. 10

CITY AND STATE: Jefferson, Oregon

SE 1/4 SW 1/4 Sec. 20 T. 10 N. S. R. 2 W., W.M.

Bearing and distance from section or subdivision corner 1237 feet North 70° West of SW Corner, Section 20

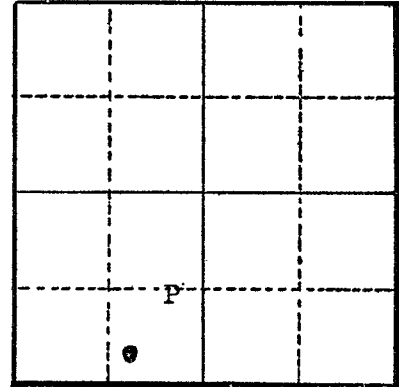

Section 20

Altitude at well 226 feet

TYPE OF WELL: Drilled Date Constructed 1950

Depth drilled 25 feet Depth cased

### CASING RECORD:

8-inch casing

### FINISH:

### AQUIFERS:

### WATER LEVEL:

9' 2"

PUMPING EQUIPMENT: Type Pacific H.P.  
Capacity G.P.M.

### WELL TESTS:

Drawdown 5 ft. after 600 hours G.P.M.  
Drawdown ft. after hours G.P.M.

USE OF WATER Irrigation Temp. °F., 19

SOURCE OF INFORMATION GR-4151

DRILLER or DIGGER Bill Hamilton Albany

### ADDITIONAL DATA:

Log (NA) Water Level Measurements Chemical Analysis Aquifer Test

### REMARKS: