

STATE ENGINEER
Salem, Oregon

Well Record

STATE WELL NO. 10/2W - 24K
COUNTY LINN
APPLICATION NO. GR-2284

Linn
4290

OWNER: James S. Ruby


MAILING ADDRESS: Route 3, Box 17

LOCATION OF WELL: Owner's No.

CITY AND STATE: Scio, Oregon

NW 1/4 SE 1/4 Sec. 24 T. 10 N. S., R. 2 E. W., W.M.

Bearing and distance from section or subdivision corner 3,036' S. and 1,518' W.

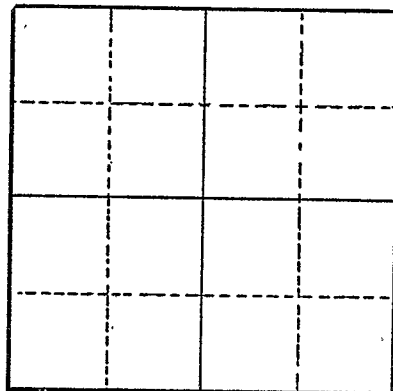

Section

Altitude at well

TYPE OF WELL: Drilled Date Constructed 1952

Depth drilled 257 Depth cased 150

CASING RECORD:

8-inch

FINISH:

AQUIFERS:

WATER LEVEL:

250-feet

PUMPING EQUIPMENT: Type Fairbanks Morse Turbine H.P. 10
Capacity 100 G.P.M.

WELL TESTS:

Drawdown 1.00 ft. after hours Pumping 60 G.P.M.
Drawdown ft. after hours G.P.M.

USE OF WATER Irrigation Temp. °F. 19

SOURCE OF INFORMATION GR-2177

DRILLER or DIGGER Mr. Rucker, Lebanon, Oregon

ADDITIONAL DATA:

Log Water Level Measurements Chemical Analysis Aquifer Test

REMARKS: