

STATE ENGINEER
Salem, Oregon

Linn
4326

Well Record

STATE WELL NO. 10/2W-28J(1)
COUNTY Linn
APPLICATION NO. GR-524

OWNER: Leo & Retta Metcalf


MAILING ADDRESS: Rt. 3, Box 85A

LOCATION OF WELL: Owner's No. 1

CITY AND STATE: Scio, Oregon

NE 1/4 SE 1/4 Sec. 28 T. 10 N. S., R. 2 E. W., W.M.

Bearing and distance from section or subdivision corner S. 15° 45' W. 20.5 chs. from NE cor. SE 1/4 Sec. 28

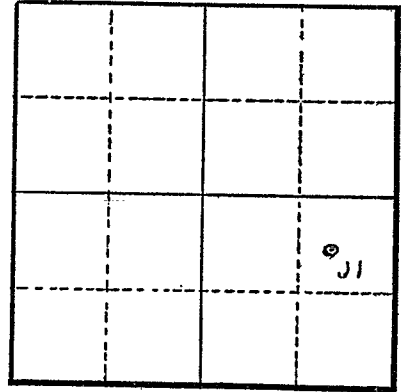

Section 28

Altitude at well 225 ft.

TYPE OF WELL: drilled Date Constructed 5/17/47

Depth drilled 30 ft. Depth cased 30 ft.

CASING RECORD: 12 inch

FINISH:

AQUIFERS:

WATER LEVEL: 12 ft.

PUMPING EQUIPMENT: Type Pacific centrifugal H.P. 10
Capacity 180 G.P.M.

WELL TESTS:
Drawdown 12 ft. after hours 90 G.P.M.
Drawdown ft. after hours G.P.M.

USE OF WATER irrigation Temp. °F. 19

SOURCE OF INFORMATION GR-524

DRILLER or DIGGER Wilbur Sloper; Independence, Oregon

ADDITIONAL DATA:

Log Water Level Measurements Chemical Analysis Aquifer Test

REMARKS: