

STATE ENGINEER
Salem, Oregon

Linn
4327

Well Record

STATE WELL NO. 10/2W-28J(2)
COUNTY Linn
APPLICATION NO. GR-525

OWNER: Leo & Retta Metcalf


MAILING ADDRESS: Rt. 3, Box 85A

LOCATION OF WELL: Owner's No. 2

CITY AND STATE: Scio, Oregon

NE 1/4 SE 1/4 Sec. 28 - T. 10 N. S., R. 2 E. W., W.M.

Bearing and distance from section or subdivision corner S. 41°15' W. 19.75 chs. from NE cor. SE 1/4 Sec. 28

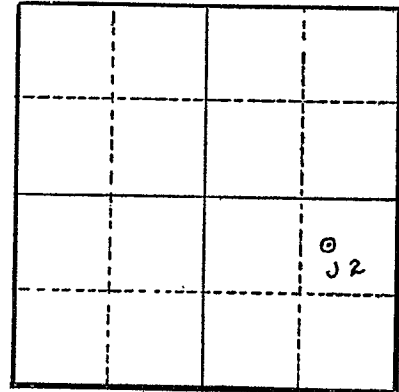

Section 28

Altitude at well 225 ft.

TYPE OF WELL: drilled Date Constructed 4/17/49

Depth drilled 27 ft. Depth cased 27 ft.

CASING RECORD: 10 inch

FINISH:

AQUIFERS:

WATER LEVEL: 12 ft.

PUMPING EQUIPMENT: Type Pacific centrifugal H.P. 10
Capacity 180 G.P.M.

WELL TESTS:

Drawdown 12 ft. after _____ hours 90 G.P.M.
Drawdown _____ ft. after _____ hours _____ G.P.M.

USE OF WATER Irrigation 16.6 acres Temp. _____ °F. _____, 19

SOURCE OF INFORMATION GR-525

DRILLER or DIGGER Nicklas Klaus; Rt. 4, Albany, Oregon

ADDITIONAL DATA:

Log _____ Water Level Measurements _____ Chemical Analysis _____ Aquifer Test _____

REMARKS: