

STATE ENGINEER
Salem, Oregon

Linn
4329

Well Record

STATE WELL NO. 10/2W-29L
COUNTY Linn
APPLICATION NO. GR-851

OWNER: Harvey Freitag


MAILING ADDRESS: 1014 E. 2nd

LOCATION OF WELL: Owner's No. 3

CITY AND STATE: Albany, Oregon

NE 1/4 SW 1/4 Sec. 29 T. 10 N. R. 2 W., W.M.

Bearing and distance from section or subdivision corner S. 61° 45' E. 37.5 chs. from NE 1/4 DLC 42

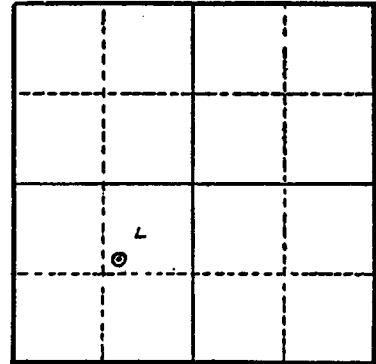

Section29.....

Altitude at well 245 ft.

TYPE OF WELL: driven Date Constructed May 1949

Depth drilled 20 ft. Depth cased 20 ft.

CASING RECORD: 3 1/2" 0 to 20 ft. steel

FINISH: Slot perforations 17 to 20 ft.

AQUIFERS:

WATER LEVEL: 8 ft.

PUMPING EQUIPMENT: Type centrifugal 2" tractor H.P.
Capacity 250 G.P.M.

WELL TESTS:
Drawdown 5 ft. after hours 300 (est) G.P.M.
Drawdown ft. after hours G.P.M.

USE OF WATER Irrigation Temp. °F. 19

SOURCE OF INFORMATION

DRILLER or DIGGER Harvey Freitag

ADDITIONAL DATA:

Log Water Level Measurements Chemical Analysis Aquifer Test

REMARKS: