

STATE ENGINEER
Salem, Oregon

Linn
4334

Well Record

STATE WELL NO. 10/2W-29L(1)
COUNTY Linn
APPLICATION NO. GR-186

OWNER: David W. & Dora E. Blakeley


MAILING ADDRESS: Rt. 2, Box 495

LOCATION OF WELL: Owner's No. 1

CITY AND STATE: Albany, Oregon

NE 1/4 SW 1/4 Sec. 29 T. 10 S., R. 2 W., W.M.

Bearing and distance from section or subdivision corner N. 58°45' E. 39 chs. from SW cor. N 1/2 of Lewis Cox DLC 44

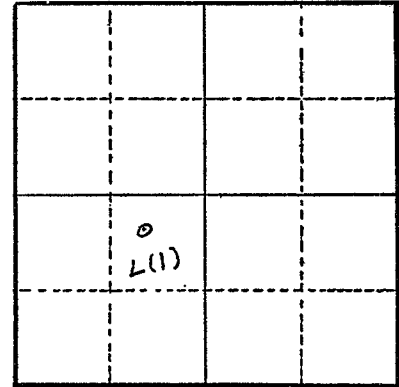

Section 29

Altitude at well 245 ft. Interpolated

TYPE OF WELL: driven Date Constructed 1945

Depth drilled 24 ft. Depth cased 24 ft.

CASING RECORD: 3 1/2 - inch steel casing set from plus 2 ft. to minus 24 ft. 26 ft. casing

FINISH: Slit perforations (1/2" wide & 12" long) around casing from 18 to 24 ft.

AQUIFERS: Gravel & rock - from 11 to 24 ft.

WATER LEVEL: 8 ft. below land surface

PUMPING EQUIPMENT: Type Denum 2 1/2" centrifugal H.P. 15
Capacity 350 G.P.M.

WELL TESTS:
Drawdown 12 ft. after hours pumping 350 G.P.M.
Drawdown ft. after hours G.P.M.

USE OF WATER Irrigation 11.2 acres Temp. °F. , 19

SOURCE OF INFORMATION Reg. St. GR-186

DRILLER or DIGGER

ADDITIONAL DATA:

Log X Water Level Measurements Chemical Analysis Aquifer Test

REMARKS:

