

STATE ENGINEER
Salem, Oregon

Well Record

STATE WELL NO. 10/2W-29M(1)
COUNTY Linn
APPLICATION NO. GR-196

Linn
4335


OWNER: Frank W. Groves

MAILING
ADDRESS:

LOCATION OF WELL: Owner's No. 1

CITY AND
STATE: Lebanon, Oregon

NW 1/4 SW 1/4 Sec. 29 T. 10 N. S., R. 2 W., W.M.

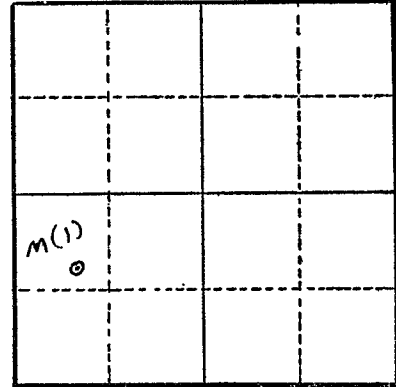

Bearing and distance from section or subdivision
corner 1600' N. & 980' W. from SW cor. Sec. 29

Section 29

Altitude at well 245 ft. Interpolated

TYPE OF WELL: dug Date Constructed June 1929

Depth drilled 19 ft. Depth cased 19 ft.

CASING RECORD: 36 in. casing from 0 to 19 ft. (tile)

FINISH: few perforations in bottom of tile

AQUIFERS: Sand and gravel from 5 to 19 ft.

WATER LEVEL: 6 ft. below land surface 1932, 34, 35

PUMPING EQUIPMENT: Type Goulds H.P. 15
Capacity 400 G.P.M.

WELL TESTS:
Drawdown 3 ft. after hours pumping 1000 G.P.M.
Drawdown ft. after hours G.P.M.

USE OF WATER irrigation 47 acres Temp. °F., 19

SOURCE OF INFORMATION Reg. St. GR-196

DRILLER or DIGGER

ADDITIONAL DATA:

Log X Water Level Measurements Chemical Analysis Aquifer Test

REMARKS: