

STATE ENGINEER
Salem, Oregon

Linn
4337

Well Record


STATE WELL NO. 10/2W-290(1)
COUNTY Linn
APPLICATION NO. GR-437

OWNER: Paul & June Smith MAILING ADDRESS: Rt. 2, Box 500

LOCATION OF WELL: Owner's No. 1 CITY AND STATE: Albany, Oregon

SW 1/4 SE 1/4 Sec. 29 T. 10 N. S., R. 2 E. W., W.M.

Bearing and distance from section or subdivision
corner N. 87° W. 35.5 chs. from SE cor. Sec. 29

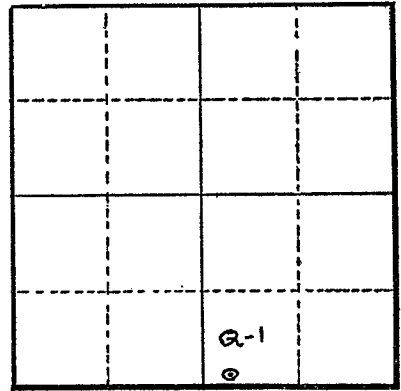

Section 29

Altitude at well 245 ft.

TYPE OF WELL: drilled Date Constructed 6/7/47

Depth drilled 21 ft. Depth cased 21 ft.

CASING RECORD: 6 inch

FINISH:

AQUIFERS:

WATER LEVEL: 10 ft.

PUMPING EQUIPMENT: Type Fairbanks Morse centrifugal H.P. 15
Capacity 400 G.P.M.

WELL TESTS:
Drawdown 3 ft. after _____ hours 400 G.P.M.
Drawdown _____ ft. after _____ hours _____ G.P.M.

USE OF WATER irrigation 29.6 acres Temp. _____ °F. _____, 19____

SOURCE OF INFORMATION GR-437

DRILLER or DIGGER Bud Slate; Tangent, Oregon

ADDITIONAL DATA:
Log _____ Water Level Measurements _____ Chemical Analysis _____ Aquifer Test _____

REMARKS: