

STATE ENGINEER
Salem, Oregon

Linn
4338

Well Record


STATE WELL NO. 10/2W-29N
COUNTY LINN
APPLICATION NO. GR-2669

OWNER: Kenneth L. Harman
MAILING ADDRESS: Rt. 2, Box 493

LOCATION OF WELL: Owner's No. _____
CITY AND STATE: Albany, Oregon

SW 1/4 SW 1/4 Sec. 29 T. 10 S. R. 2 W., W.M.

Bearing and distance from section or subdivision corner N. 52° E. 6.5 chains

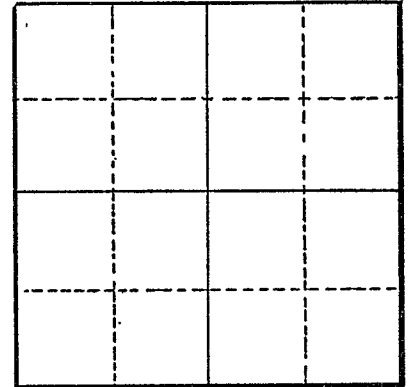

Section _____

Altitude at well _____

TYPE OF WELL: Drilled Date Constructed 1952

Depth drilled 36 Depth cased 36

CASING RECORD:

6-inch

FINISH:

Slot perforations from 30 to 36

AQUIFERS:

WATER LEVEL:

18-feet

PUMPING EQUIPMENT: Type Ward's Centrifugal H.P. 1
Capacity 50 G.P.M.

WELL TESTS:

Drawdown _____ ft. after _____ hours _____ G.P.M.
Drawdown _____ ft. after _____ hours _____ G.P.M.

USE OF WATER Irrigation Temp. _____ °F. _____, 19

SOURCE OF INFORMATION GR-2531

DRILLER or DIGGER Bill Hamilton Drilling Co., 838 E. third Ave., Albany, Oregon

ADDITIONAL DATA:

Log _____ Water Level Measurements _____ Chemical Analysis _____ Aquifer Test _____

REMARKS: