

STATE ENGINEER
Salem, Oregon

Linn
4346

Well Record

STATE WELL NO. 10/2W-30E
COUNTY Linn
APPLICATION NO. GR-1412

GR- 1366

OWNER: Elmer & Georgia Heverly


MAILING ADDRESS: Rt. 2, Box 505 C

LOCATION OF WELL: Owner's No.

CITY AND STATE: Albany, Oregon

SE 1/4 NW 1/4 Sec. 30 T. 10 S., R. 2 W., W.M.

Bearing and distance from section or subdivision corner N.80°20'W. 12 ch. from NW cor. DIG. #42

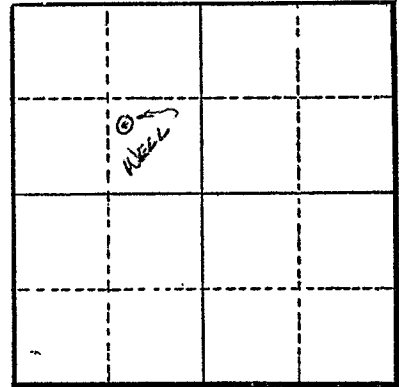

Section30.....

Altitude at well 230 ft.

TYPE OF WELL: Drilled Date Constructed 1950

Depth drilled 30 ft. Depth cased 30 ft.

CASING RECORD:

10 inch

FINISH:

Slot perforations from 22 to 30 ft.

AQUIFERS:

WATER LEVEL:

10 ft.

PUMPING EQUIPMENT: Type Myers 3" Cent. H.P. 20

Capacity 450 G.P.M.

WELL TESTS:

Drawdown 3 ft. after 450 hours G.P.M.

Drawdown ft. after hours G.P.M.

USE OF WATER Irrigation Temp. °F., 19

SOURCE OF INFORMATION G. R. Record

DRILLER or DIGGER

ADDITIONAL DATA:

Log N.A. Water Level Measurements Chemical Analysis Aquifer Test

REMARKS:

Irrigation of 46 acres.