

STATE ENGINEER
Salem, Oregon

Linn
4347

Well Record


STATE WELL NO. 10/2W-30J
COUNTY Linn
APPLICATION NO. GR-849

OWNER: Harvey Freitag
MAILING ADDRESS: 101 1/2 E. 2nd

LOCATION OF WELL: Owner's No. 1
CITY AND STATE: Albany, Oregon

NE 1/4 SE 1/4 Sec. 30 T. 10 S., R. 2 W., W.M.

Bearing and distance from section or subdivision
corner S. 24° 10' E. 11.5 chs. from NE cor. DLC 42

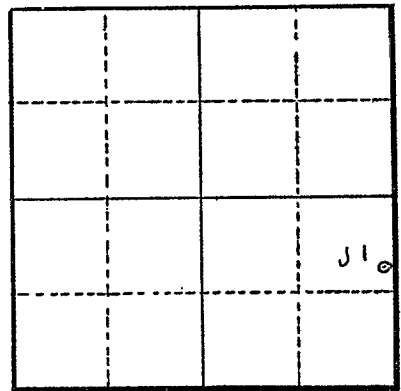

Section 30

Altitude at well 245 ft.

TYPE OF WELL: driven Date Constructed June 1951

Depth drilled 19 ft. Depth cased

CASING RECORD: 4 in. steel 0 to 19 ft.

FINISH: slot perforated 16 to 19 ft.

AQUIFERS:

WATER LEVEL: 8 ft.

PUMPING EQUIPMENT: Type Allis Chalmers 2 1/2" centrifugal H.P. 10 elec.
Capacity 250 G.P.M.

WELL TESTS:
Drawdown 3 ft. ft. after hours 400 (est) G.P.M.
Drawdown ft. after hours G.P.M.

USE OF WATER Temp. °F., 19

SOURCE OF INFORMATION owner
DRILLER or DIGGER Harvey Freitag

ADDITIONAL DATA:
Log Water Level Measurements Chemical Analysis Aquifer Test

REMARKS: