

STATE ENGINEER
Salem, Oregon

Linn
4348

Well Record


STATE WELL NO. 10/2W-30J(2)
COUNTY Linn
APPLICATION NO.

OWNER: Harvey Freitag
MAILING ADDRESS: 1011 E. 2nd

LOCATION OF WELL: Owner's No.
CITY AND STATE: Albany, Oregon

NE 1/4 SE 1/4 Sec. 30 T. 10 N. S., R. 2 E. W., W.M.

Bearing and distance from section or subdivision
corner S. 66° 10' W. 11 chs. from NE cor. D.L.C. 42

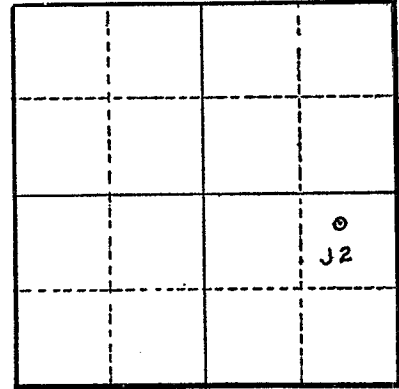

Section 30

Altitude at well 245 ft.

TYPE OF WELL: driven Date Constructed June 1951

Depth drilled 14 ft. Depth cased 14 ft.

CASING RECORD: 4 in. steel 0 to 14 ft.

FINISH: Slot perforations 11 to 14 ft.

AQUIFERS:

WATER LEVEL: 8 ft.

PUMPING EQUIPMENT: Type H.P.
Capacity G.P.M.

WELL TESTS:
Drawdown 4 ft. after hours 130 (est) G.P.M.
Drawdown ft. after hours G.P.M.

USE OF WATER irrigation Temp. °F., 19

SOURCE OF INFORMATION owner

DRILLER or DIGGER Harvey Freitag

ADDITIONAL DATA:
Log Water Level Measurements Chemical Analysis Aquifer Test

REMARKS: