

STATE ENGINEER
Salem, Oregon

Linn
4349

Well Record

STATE WELL NO. 10/2W-30L
COUNTY Linn
APPLICATION NO. GR-900

OWNER: Loyd J. Porter


MAILING ADDRESS: Rt. 1, Box 269

LOCATION OF WELL: Owner's No.

CITY AND STATE: Albany, Oregon

NE 1/4 SW 1/4 Sec. 30 T. 10 S., R. 2 W., W.M.

Bearing and distance from section or subdivision
corner S. 4° 30' W. 23.5 chs. from NW cor. DLC 42

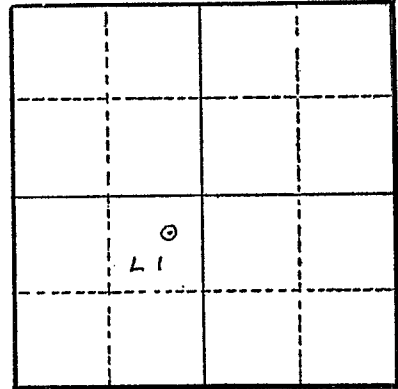

Section 30

Altitude at well 240

TYPE OF WELL: drilled Date Constructed April 1949

Depth drilled 26 ft. Depth cased 26 ft.

CASING RECORD: 6 inch steel casing from 0 to 26 ft.

FINISH: Not perforated

AQUIFERS:

WATER LEVEL: 14 ft.

PUMPING EQUIPMENT: Type centrifugal 3 inch H.P. 15 elec.
Capacity 400 G.P.M.

WELL TESTS:
Drawdown 4 ft. after 600 hours G.P.M.
Drawdown ft. after hours G.P.M.

USE OF WATER irrigation Temp. °F. 19

SOURCE OF INFORMATION owner
DRILLER or DIGGER Nicholas Klaus; Rt. 4, Albany, Oregon

ADDITIONAL DATA:
Log Water Level Measurements Chemical Analysis Aquifer Test

REMARKS: