

STATE ENGINEER
Salem, Oregon

Linn
4350

Well Record

STATE WELL NO. 10/2W-30L
COUNTY LINN
APPLICATION NO. GR-2458

OWNER: O. W. Martin


MAILING ADDRESS: Rt. 2, Box 506

LOCATION OF WELL: Owner's No.

CITY AND STATE: Albany, Oregon

NE 1/4 SW 1/4 Sec. 30 T. 10 S., R. 2 W., W.M.

Bearing and distance from section or subdivision corner 2277' N. and 1617' E.

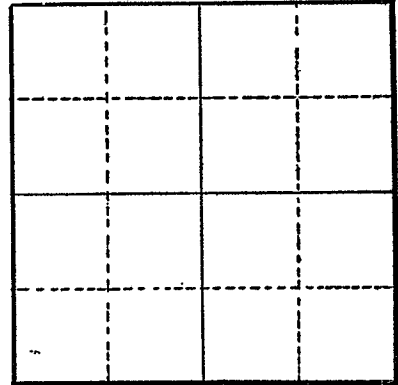

Section

Altitude at well

TYPE OF WELL: Drilled Date Constructed 1945

Depth drilled 31 Depth cased

CASING RECORD:

8-inch

FINISH:

Perforations (last 6' from bottom) from 25 to 31

AQUIFERS:

WATER LEVEL:

15-feet

PUMPING EQUIPMENT: Type Fairbanks Morse 3" Centrifugal H.P. 15
Capacity 300 G.P.M.

WELL TESTS:

Drawdown 4 ft. after Unknown hours G.P.M.
Drawdown ft. after hours G.P.M.

USE OF WATER Irrigation Temp. °F., 19

SOURCE OF INFORMATION GR-2329

DRILLER or DIGGER Mr. Sloper, Independence

ADDITIONAL DATA:

Log Water Level Measurements Chemical Analysis Aquifer Test

REMARKS: