

STATE ENGINEER
Salem, Oregon

Linn
4351

Well Record

GR- 1412

STATE WELL NO. 10/2W-30K
COUNTY Linn
APPLICATION NO. GR- 1463

OWNER: Glenn D. & Naomi Roth


MAILING ADDRESS: Rt. 2, Box 505

LOCATION OF WELL: Owner's No. #1

CITY AND STATE: Albany, Oregon

NW 1/4 SE 1/4 Sec. 30 T. 10 S., R. 2 W., W.M.

Bearing and distance from section or subdivision
corner 1617' N. & 3200' E. from SW cor. Sec. 30

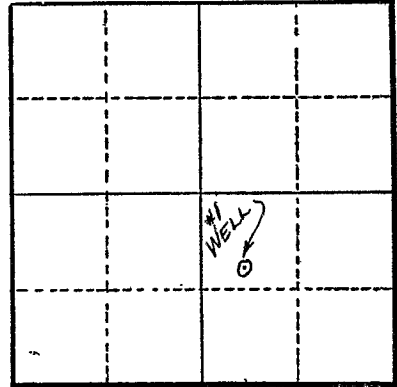

Section 30

Altitude at well 220'

TYPE OF WELL: Drilled Date Constructed 1945

Depth drilled 30' Depth cased 30'

CASING RECORD:

8"

FINISH:

Slot perforations from 22' to 30'

AQUIFERS:

WATER LEVEL:

8'

PUMPING EQUIPMENT: Type Goulds 2" Cent. H.P. 15

Capacity 350 G.P.M.

WELL TESTS:

Drawdown ft. after hours G.P.M.

Drawdown ft. after hours G.P.M.

USE OF WATER Irrigation Temp. °F., 19.....

SOURCE OF INFORMATION GR Record

DRILLER or DIGGER

ADDITIONAL DATA:

Log N.A. Water Level Measurements Chemical Analysis Aquifer Test

REMARKS:

Irrigation of 79.4 acres