

STATE ENGINEER
Salem, Oregon

Linn
4353

Well Record

STATE WELL NO. 10/2W-30P
COUNTY Linn
APPLICATION NO. CR-3249

OWNER: Loren J. and Lulu O Bond


MAILING ADDRESS: Route 2, Box 507

LOCATION OF WELL: Owner's No.

CITY AND STATE: Albany, Oregon

SE 1/4 SW 1/4 Sec. 30 T. 10 S., R. 2 W., W.M.

Bearing and distance from section or subdivision corner 1254' N. and 1716' E. of the S.W. corner of Section 30

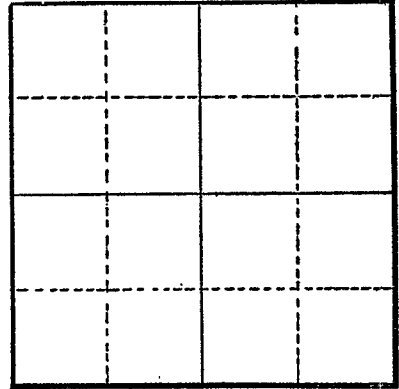

Section

Altitude at well

TYPE OF WELL: drilled Date Constructed 1948

Depth drilled 23 1/2 Depth cased 23 1/2

CASING RECORD:

6 inch

FINISH:

Slot perforations from 19 1/2 to 23 1/2

AQUIFERS:

WATER LEVEL:

12 feet

PUMPING EQUIPMENT: Type Allis Chalmers Centrifugal H.P. 5
Capacity G.P.M.

WELL TESTS:

Drawdown ft. after hours G.P.M.
Drawdown ft. after hours G.P.M.

USE OF WATER Irrigation Temp. °F., 19

SOURCE OF INFORMATION CR-3023

DRILLER or DIGGER Sloper, Independence, Oregon

ADDITIONAL DATA:

Log Water Level Measurements Chemical Analysis Aquifer Test

REMARKS: