

STATE ENGINEER
Salem, Oregon

Linn
4354

Well Record

STATE WELL NO. 10/2W-300
COUNTY Linn
APPLICATION NO. GR-1464

GR- 1413

OWNER: Glenn D. & Naomi Roth


MAILING ADDRESS: Rt. 2, Box 505

LOCATION OF WELL: Owner's No. #2

CITY AND STATE: Albany, Oregon

SW 1/4 SE 1/4 Sec. 30 T. 10 S., R. 2 W., W.M.

Bearing and distance from section or subdivision corner 759' N. & 3300' E. from SW cor. Sec. 30

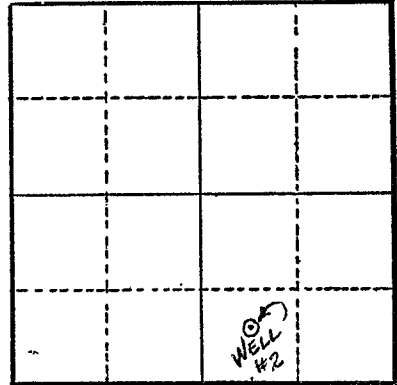

Section 30

Altitude at well 220'

TYPE OF WELL: Drilled Date Constructed 1947

Depth drilled 32' Depth cased 32'

CASING RECORD:

8"

FINISH:

Slot perforations from 24' to 32'

AQUIFERS:

WATER LEVEL:

8'

PUMPING EQUIPMENT: Type Goulds 2" Cent. H.P. 15

Capacity 350 G.P.M.

WELL TESTS:

Drawdown ft. after hours G.P.M.

Drawdown ft. after hours G.P.M.

USE OF WATER Irrigation Temp. °F., 19

SOURCE OF INFORMATION GR Record

DRILLER or DIGGER

ADDITIONAL DATA:

Log N.A. Water Level Measurements Chemical Analysis Aquifer Test

REMARKS:

Irrigation of 79.4 acres