

STATE ENGINEER
Salem, Oregon

Linn
4361

Well Record


STATE WELL NO. 10/2W-31H
COUNTY LINN
~~APPLICATION NO. GR-2407~~

OWNER: Orie H. Cox
MAILING ADDRESS: Rt. 2, Box 480

LOCATION OF WELL: Owner's No. _____
CITY AND STATE: Albany, Oregon

SE 1/4 NE 1/4 Sec. 31 T. 10 S., R. 2 W., W.M.

Bearing and distance from section or subdivision
corner N. 78° 40' W. 17.3 chains

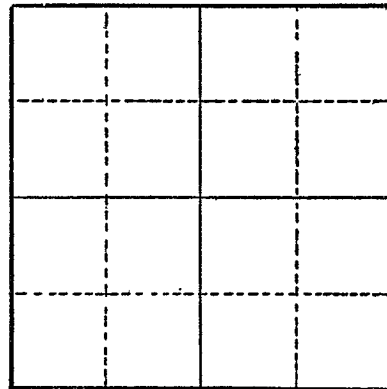

Section _____

Altitude at well _____

TYPE OF WELL: Drilled Date Constructed 1951

Depth drilled 37 Depth cased 30

CASING RECORD:

6-inch

FINISH:

Slot perforations from 20 to 30

AQUIFERS:

WATER LEVEL:

20-feet

PUMPING EQUIPMENT: Type Allis Chalmers Centrifugal H.P. 3
Capacity 75 G.P.M.

WELL TESTS:

Drawdown _____ ft. after _____ hours _____ G.P.M.
Drawdown _____ ft. after _____ hours _____ G.P.M.

USE OF WATER Irrigation Temp. _____ °F. _____, 19_____

SOURCE OF INFORMATION GR-2288

DRILLER or DIGGER Nicholas Klaus, Rt. 4, Albany, Oregon

ADDITIONAL DATA:

Log _____ Water Level Measurements _____ Chemical Analysis _____ Aquifer Test _____

REMARKS: