

STATE ENGINEER
Salem, Oregon

LINN
4385

Well Record

STATE WELL NO. 10/2W-32A(1)
COUNTY Linn
APPLICATION NO. GR-526

OWNER: M. H. Gildersleeve

MAILING ADDRESS: Rt. 2, Box 489


LOCATION OF WELL: Owner's No.

CITY AND STATE: Albany, Oregon

NE 1/4 NE 1/4 Sec. 32 T. 10 N. S. R. 2 W., W.M.

Bearing and distance from section or subdivision corner N. 43° 15' W. 13 chs. from SE cor.

Lewis Cox DLC 44

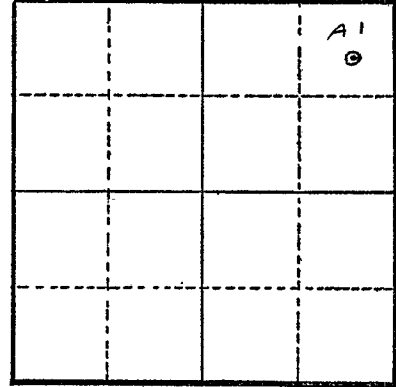

Section 32

Altitude at well 250 ft.

TYPE OF WELL: drilled Date Constructed May 1952

Depth drilled 89 ft. Depth cased 89 ft.

CASING RECORD: 10 inch

FINISH:

AQUIFERS:

WATER LEVEL: 8 ft.

PUMPING EQUIPMENT: Type Fairbanks Morse turbine H.P. 10
Capacity 270 G.P.M.

WELL TESTS:
Drawdown 2 ft. after hours 270 G.P.M.
Drawdown ft. after hours G.P.M.

USE OF WATER irrigation 28.9 acres Temp. °F. 19

SOURCE OF INFORMATION GR-526

DRILLER or DIGGER

ADDITIONAL DATA:

Log Water Level Measurements Chemical Analysis Aquifer Test

REMARKS: