

STATE ENGINEER
Salem, Oregon

LINN
4389

Well Record


STATE WELL NO. 10/2W-32H(1)
COUNTY Linn
APPLICATION NO. GR-167

OWNER: Plagmann Farms MAILING ADDRESS: Rt. 2, Box 487

LOCATION OF WELL: Owner's No. 1 CITY AND STATE: Albany, Oregon

SE 1/4 NE 1/4 Sec. 32 T. 10 S., R. 2 W., W.M.

Bearing and distance from section or subdivision corner S. 26° E. 11.0 chs. from SE cor. Lewis Cox DIC 14

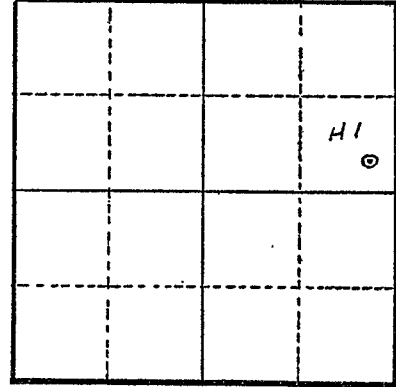

Section 32

Altitude at well 250 ft. Interpolated

TYPE OF WELL: drilled Date Constructed 1935

Depth drilled 22 ft. Depth cased 22 ft.

CASING RECORD: 12 - inch steel casing set from 0 to 22 ft.

FINISH: Perforations set from 17 to 22 ft.

AQUIFERS: unknown

WATER LEVEL: 4 ft. below land surface

PUMPING EQUIPMENT: Type Fairbanks Morse centrifugal H.P. 20
Capacity 600 G.P.M.

WELL TESTS:
Drawdown 8 ft. after hours pumping 800 G.P.M.
Drawdown ft. after hours G.P.M.

USE OF WATER Irrigation 42 acres Temp. °F., 19

SOURCE OF INFORMATION Reg. St. GR-167

DRILLER or DIGGER William Sloper; Rt. 4, Albany, Oregon

ADDITIONAL DATA:

Log Water Level Measurements Chemical Analysis Aquifer Test

REMARKS: