

STATE ENGINEER
Salem, Oregon

LINN
4390

Well Record

STATE WELL NO. 10/2W-32J(1)
COUNTY Linn
APPLICATION NO. GR-167

OWNER: Plagmann Farms


MAILING ADDRESS: Rt. 2, Box 487

LOCATION OF WELL: Owner's No. 2

CITY AND STATE: Albany, Oregon

NE 1/4 SE 1/4 Sec. 32 T. 10 N. S. R. 2 W., W.M.

Bearing and distance from section or subdivision corner N. 10°43' W. 29.5 chs. from NE cor. John A. Powell DLC 38

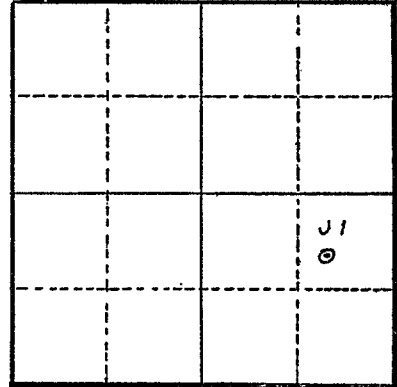

Section 32

Altitude at well 250 ft. Interpolated

TYPE OF WELL: drilled Date Constructed 1940

Depth drilled 20 ft. Depth cased 20 ft.

CASING RECORD: 12 - inch steel casing set from 0 to 20 ft.

FINISH: perforated from 17 to 22 ft.

AQUIFERS: unknown

WATER LEVEL: 8 ft. below land surface

PUMPING EQUIPMENT: Type 3" Wyss centrifugal H.P. 20
Capacity 600 G.P.M.

WELL TESTS:
Drawdown 10 ft. after hours pumping 800 G.P.M.
Drawdown ft. after hours G.P.M.

USE OF WATER irrigation 40 acres Temp. °F. 19

SOURCE OF INFORMATION Reg. St. GR-167


ADDITIONAL DATA:

Log Water Level Measurements Chemical Analysis Aquifer Test

REMARKS: