

STATE ENGINEER  
Salem, Oregon

LINN  
4391

# Well Record

STATE WELL NO. 10/2W-32K(1)  
COUNTY Linn  
APPLICATION NO. GR-167

OWNER: Plagmann Farms


MAILING ADDRESS: Rt. 2, Box 487

LOCATION OF WELL: Owner's No. 4

CITY AND STATE: Albany, Oregon

NW 1/4 SE 1/4 Sec. 32 T. 10 N. S. R. 2 E. W., W.M.

Bearing and distance from section or subdivision corner N. 40° 30' W. 39.5 chs. from NE cor. John A. Powell DLC 38

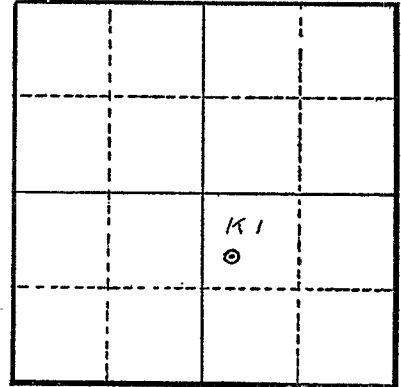

Section 32

Altitude at well 250 ft. Interpolated

TYPE OF WELL: drilled Date Constructed 1943

Depth drilled 8 ft. Depth cased 8 ft.

CASING RECORD: 8 - inch steel casing set from 0 to 8 ft.

FINISH: perforations set from 3 to 8 ft.

AQUIFERS: unknown

WATER LEVEL: 2 ft. below land surface

PUMPING EQUIPMENT: Type Fairbanks Morse centrifugal H.P. 15  
Capacity 500 G.P.M.

WELL TESTS:  
Drawdown 3 ft. after ..... hours pumping 1000 G.P.M.  
Drawdown ..... ft. after ..... hours ..... G.P.M.

USE OF WATER irrigation 40 acres Temp. °F. 19

SOURCE OF INFORMATION Reg. St. GR-167

DRILLER or DIGGER J. T. Burkhart; 169 N. 1st, W. Tremonton, Utah

ADDITIONAL DATA:

Log ..... Water Level Measurements ..... Chemical Analysis ..... Aquifer Test .....

REMARKS: