

STATE ENGINEER  
Salem, Oregon


LINN  
4392

# Well Record

STATE WELL NO. 10/2W-32K(2)  
COUNTY Linn  
APPLICATION NO. GR-167

OWNER: Plagmann Farms MAILING ADDRESS: Rt. 2, Box 187  
LOCATION OF WELL: Owner's No. 5 CITY AND STATE: Albany, Oregon

NW  $\frac{1}{4}$  SE  $\frac{1}{4}$  Sec. 32 T. 10 S., R. 2 W., W.M.  
Bearing and distance from section or subdivision corner N. 34° 15' W. 36.5 chs. from NE cor.  
John A. Powell DLC 38

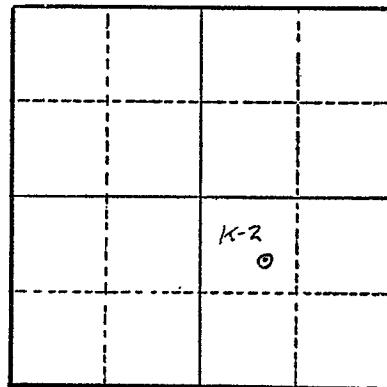

Section 32

Altitude at well 250 ft. Interpolated

TYPE OF WELL: Dug Date Constructed 1944

Depth drilled 20 ft. Depth cased none

CASING RECORD: pit - no casing

FINISH: none

AQUIFERS: unknown

WATER LEVEL: 6 ft. below land surface

PUMPING EQUIPMENT: Type 3" Wyss centrifugal H.P. 15  
Capacity 400 G.P.M.

WELL TESTS:  
Drawdown 4 ft. after                      hours pumping 800 G.P.M.  
Drawdown                      ft. after                      hours                      G.P.M.

USE OF WATER irrigation 32 acres Temp.                      °F.                     , 19                    

SOURCE OF INFORMATION Reg. St. GR-167

DRILLER or DIGGER Albany Sand & gravel

ADDITIONAL DATA:  
Log                      Water Level Measurements                      Chemical Analysis                      Aquifer Test                     

REMARKS: