

STATE ENGINEER  
Salem, Oregon

LINN  
4393

# Well Record

STATE WELL NO. 10/2W-32K(3)  
COUNTY Linn  
APPLICATION NO. GR-167

OWNER: Plagmann Farms


MAILING ADDRESS: Rt. 2, Box 487

LOCATION OF WELL: Owner's No. 6

CITY AND STATE: Albany, Oregon

NW 1/4 SE 1/4 Sec. 32 T. 10 N. S. R. 2 E. W., W.M.

Bearing and distance from section or subdivision  
corner N. 25° 15' W. 34.5 chs. from NE cor.  
John A. Powell DLC 38

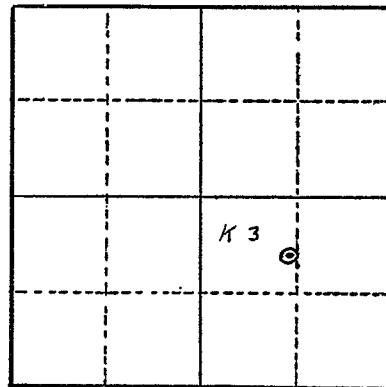

Section 32

Altitude at well 250 ft. Interpolated

TYPE OF WELL: drilled Date Constructed 1938

Depth drilled 30 ft. Depth cased 30 ft.

CASING RECORD: 4 - inch steel pipe set from 0 to 30 ft.

FINISH: perforated from 25 to 30 ft.

AQUIFERS: unknown

WATER LEVEL: 10 ft. below land surface

PUMPING EQUIPMENT: Type 2" Fairbanks Morse centrifugal H.P. 10  
Capacity 250 G.P.M.

WELL TESTS:  
Drawdown 25 ft. after ..... hours pumping 125 G.P.M.  
Drawdown ..... ft. after ..... hours ..... G.P.M.

USE OF WATER Mint still manufac. 125 gpm Temp. °F. ...., 19.....

SOURCE OF INFORMATION Reg. St. GR-167

DRILLER or DIGGER T. J. Burkhart; 169 N. 1st, W. Tremonton, Utah

ADDITIONAL DATA:

Log ..... Water Level Measurements ..... Chemical Analysis ..... Aquifer Test .....

REMARKS: