

STATE ENGINEER
Salem, Oregon

LINN
4394

Well Record

STATE WELL NO. 10/2W-32R
COUNTY Linn
APPLICATION NO. GR-897

OWNER: P.W. & Florence E. Drushella MAILING ADDRESS: Rt. 3

LOCATION OF WELL: Owner's No. 1 CITY AND STATE: Scio, Oregon


SE 1/4 SE 1/4 Sec. 32 T. 10 N. S., R. 2 W., W.M.

Bearing and distance from section or subdivision corner N. 22° W. 13 chs. from SE cor. Sec. 33

Altitude at well 264 ft.

TYPE OF WELL: drilled Date Constructed 1951

Depth drilled 33 ft. Depth cased 33 ft.

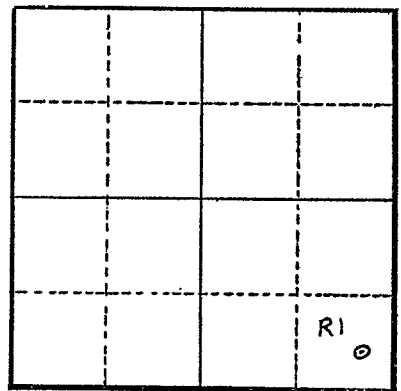

Section 32

CASING RECORD: 10 inch steel casing from 0 to 33 ft.

FINISH: Slot perforations from 25 to 33 ft.

AQUIFERS:

WATER LEVEL: 13 ft.

PUMPING EQUIPMENT: Type H.P.
Capacity G.P.M.

WELL TESTS:
Drawdown 20 ft. after hours 600 (estimated) G.P.M.
Drawdown ft. after hours G.P.M.

USE OF WATER irrigation Temp. °F. 19

SOURCE OF INFORMATION owner

DRILLER or DIGGER Nickolas Klaus; Rt. 4, Albany, Oregon

ADDITIONAL DATA:
Log Water Level Measurements Chemical Analysis Aquifer Test

REMARKS: