

STATE ENGINEER  
Salem, Oregon

LINN  
4401

# Well Record

STATE WELL NO. 10. /2W -33B  
COUNTY LINN  
APPLICATION NO. GR-1962

OWNER: Frank S. Perry


MAILING ADDRESS: Route 3

LOCATION OF WELL: Owner's No.

CITY AND STATE: Scio, Oregon

NW 1/4 NE 1/4 Sec. 33 T. 10 N. S., R. 2 W., W.M.

Bearing and distance from section or subdivision corner S. 60° 15' W. 27.5 chains from NE corner

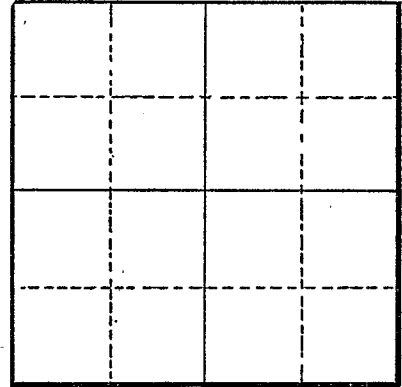

Section

Altitude at well

TYPE OF WELL: Drilled Date Constructed 1940

Depth drilled 30 Depth cased 30

### CASING RECORD:

10-inch

### FINISH:

Perforations from 12 to 30

### AQUIFERS:

Not available

### WATER LEVEL:

10-feet

PUMPING EQUIPMENT: Type Fairbanks Morse Centrifugal H.P. 10  
Capacity 300 G.P.M.

### WELL TESTS:

Drawdown 5 ft. after hours Pumping 300 G.P.M.  
Drawdown ft. after hours G.P.M.

USE OF WATER Irrigation Temp. °F., 19.

SOURCE OF INFORMATION GR-1890

DRILLER or DIGGER

### ADDITIONAL DATA:

Log Water Level Measurements Chemical Analysis Aquifer Test

### REMARKS: