

STATE ENGINEER
Salem, Oregon

LINN
4402


Well Record

STATE WELL NO. 10/2W-33G
COUNTY LINN
APPLICATION NO. GR-2401

OWNER: Philip J. and Della M. Braden
MAILING ADDRESS: Route 3, Box 88

LOCATION OF WELL: Owner's No. _____
CITY AND STATE: Scio, Oregon

SW 1/4 NE 1/4 Sec. 33 T. 10 S. R. 2 W., W.M.
Bearing and distance from section or subdivision
corner 726' N. and 1551' W.

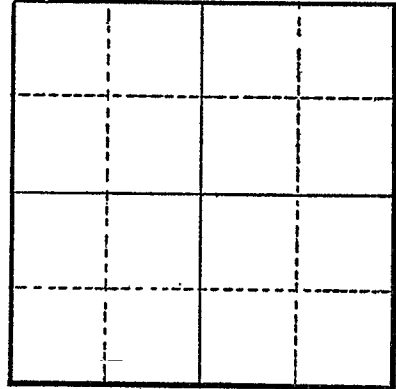

Section _____

Altitude at well _____

TYPE OF WELL: Drilled Date Constructed 1948
Depth drilled 28 Depth cased 28

CASING RECORD:

10-inch

FINISH:

Slot perforations from 14 to 28

AQUIFERS:

WATER LEVEL:

10-feet

PUMPING EQUIPMENT: Type Fairbanks Morse Centrifugal H.P. 10
Capacity 300 G.P.M.

WELL TESTS:

Drawdown 18 ft. after _____ hours Pumping 150 G.P.M.
Drawdown _____ ft. after _____ hours _____ G.P.M.

USE OF WATER Irrigation Temp. _____ °F. _____, 19

SOURCE OF INFORMATION GR-2282
DRILLER or DIGGER Bill Hamilton Well Drilling Co., Albany, Oregon

ADDITIONAL DATA:

Log _____ Water Level Measurements _____ Chemical Analysis _____ Aquifer Test _____

REMARKS:

5