

STATE ENGINEER
Salem, Oregon

LINN
4447

Well Record


STATE WELL NO. 10/3W-3E(1)
COUNTY Linn
APPLICATION NO. GR-373

OWNER: Elton I. & Mildred Higbee & H. & P. Turnidge
MAILING ADDRESS: Rt. 2, Box 369

LOCATION OF WELL: Owner's No. 2
CITY AND STATE: Albany, Oregon

SW 1/4 NW 1/4 Sec. 3 T. 10 N. S. R. 3 E. W., W.M.

Bearing and distance from section or subdivision corner N. 30° 20' E. 20.5 chs. from SE cor. NE 1/4 Sec. 4,

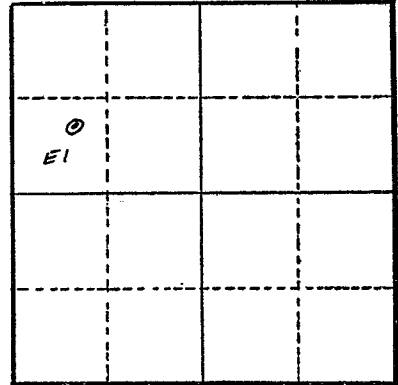

Section 3

Altitude at well 195 ft. Interpolated

TYPE OF WELL: drilled Date Constructed 4-19-46

Depth drilled 24 ft. Depth cased 20 ft.

CASING RECORD: 10 - inch steel casing set from 0 to 20 ft.

FINISH: Slit perforations from 12 to 20 ft.

AQUIFERS: gravel from 9 to 20 ft.

WATER LEVEL: 10 ft. below land surface

PUMPING EQUIPMENT: Type Fairbanks Morse 3" centrifugal H.P. 15
Capacity 300 G.P.M.

WELL TESTS:
Drawdown 3 ft. after hours pumping 600 G.P.M.
Drawdown ft. after hours G.P.M.

USE OF WATER irrigation 52.0 acres Temp. °F., 19

SOURCE OF INFORMATION Reg. St. GR-373

DRILLER or DIGGER

ADDITIONAL DATA:
Log Water Level Measurements Chemical Analysis Aquifer Test

REMARKS: Log: Soil 0 to 6 ft.
Sand 6 to 9 ft.
Gravel 9 to 20 ft.