

STATE ENGINEER  
Salem, Oregon

LINN  
4448

# Well Record


STATE WELL NO. 10/3W-3E(2)  
COUNTY Linn  
APPLICATION NO. GR-374

OWNER: Elton I. & Mildred S. Higbee MAILING ADDRESS: Rt. 2, Box 369

LOCATION OF WELL: Owner's No. 2 CITY AND STATE: Albany, Oregon

SW 1/4 NW 1/4 Sec. 3 T. 10<sup>N.</sup> S, R. 3<sup>E.</sup> W., W.M.

Bearing and distance from section or subdivision corner N. 70° 30' 10.75 chs. from SW cor. NW 1/4 Sec. 3

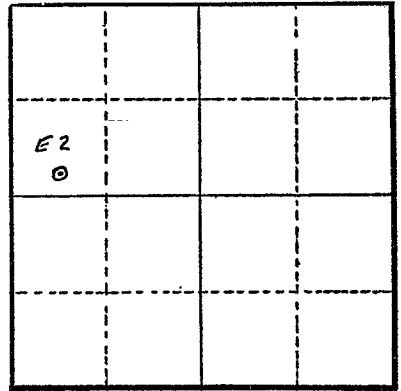

Section 3

Altitude at well 200 ft. interpolated

TYPE OF WELL: drilled Date Constructed 1-10-48

Depth drilled 27 ft. Depth cased 27 ft.

CASING RECORD: 8 - in. steel casing set from 0 to 27 ft.

FINISH: Torch slots cut 3" long from 23 to 27 ft. (staggered)

AQUIFERS: unknown

WATER LEVEL: 12 ft. below land surface

PUMPING EQUIPMENT: Type 1 1/2" Fairbanks Morse centrifugal H.P. 7 1/2  
Capacity 150 G.P.M.

WELL TESTS:  
Drawdown 2 ft. after ..... hours pumping 300 G.P.M.  
Drawdown ..... ft. after ..... hours ..... G.P.M.

USE OF WATER irrigation 15.2 acres Temp. ..... °F. ...., 19

SOURCE OF INFORMATION Reg. St. GR-374

DRILLER or DIGGER Bill Hamilton

ADDITIONAL DATA:  
Log ..... Water Level Measurements ..... Chemical Analysis ..... Aquifer Test .....

REMARKS: