

STATE ENGINEER  
Salem, Oregon

LINN  
4454

# Well Record


STATE WELL NO. 10/3W - 3M  
COUNTY LINN  
APPLICATION NO. GR-2197

OWNER: Clarence and Helen A. MacLean MAILING ADDRESS: Rt. 1, Box 135

LOCATION OF WELL: Owner's No. CITY AND STATE: Jefferson, Oregon

N. 1/4 SW 1/4 Sec. 3 T. 10 S., R. 3 W., W.M.

Bearing and distance from section or subdivision corner S. 1° 40' E. 19.2 Chains from the NW corner.

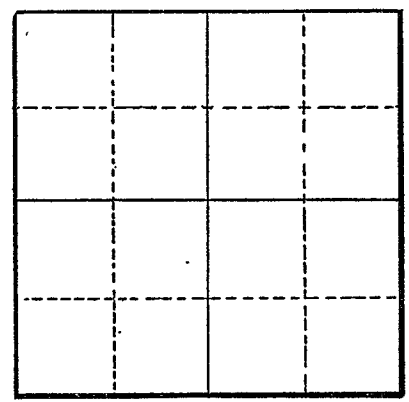

Section

Altitude at well

TYPE OF WELL: Drilled Date Constructed 1950

Depth drilled 25 Depth cased 25

### CASING RECORD:

8-Inch

### FINISH:

Perforations from 20 to 25

### AQUIFERS:

### WATER LEVEL:

12-Feet

PUMPING EQUIPMENT: Type Centrifugal H.P. 5  
Capacity 150 G.P.M.

### WELL TESTS:

Drawdown ft. after hours G.P.M.  
Drawdown ft. after hours G.P.M.

USE OF WATER Irrigation Temp. °F., 19

SOURCE OF INFORMATION GR-2102  
DRILLER or DIGGER Bill Hamilton Drilling Co., 838 E. Third Ave., Albany, Oregon

### ADDITIONAL DATA:

Log Water Level Measurements Chemical Analysis Aquifer Test

### REMARKS: