

STATE ENGINEER
Salem, Oregon

LINN
4455

Well Record


STATE WELL NO. 10/3W-3M(1)
COUNTY Linn
APPLICATION NO. GR-385

OWNER: Wm. Schwab
MAILING ADDRESS: Rt. 2, Box 371

LOCATION OF WELL: Owner's No. 1
CITY AND STATE: Albany, Oregon

NW 1/4 SE 1/4 Sec. 3 T. 10 N. S., R. 3 E. W., W.M.

Bearing and distance from section or subdivision
corner S. 73° E. 10.5 chs. from NW cor. SW 1/4,
Sec. 3

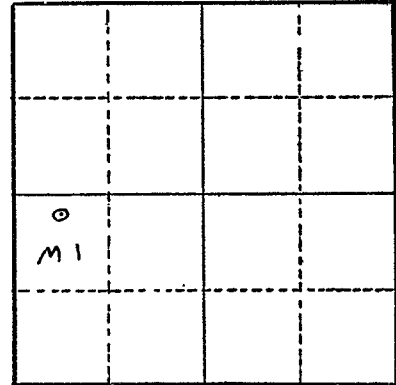

Section 3

Altitude at well 200 ft. Interpolated

TYPE OF WELL: drilled Date Constructed 5/10/52

Depth drilled 23 ft. Depth cased 23 ft.

CASING RECORD: 10 - inch casing set from 0 to 23 ft.

FINISH: Silt perforations from 18 to 23 ft.

AQUIFERS: Sand & gravel from 8 to 23 ft.

WATER LEVEL: 11 ft. below land surface

PUMPING EQUIPMENT: Type Fairbanks Morse centrifugal H.P. 15
Capacity 300 G.P.M.

WELL TESTS:
Drawdown 3 ft. after _____ hours pumping 300 G.P.M.
Drawdown _____ ft. after _____ hours _____ G.P.M.

USE OF WATER irrigation 28 acres Temp. _____ °F., 19

SOURCE OF INFORMATION Reg. St. GR-385

DRILLER or DIGGER _____

ADDITIONAL DATA:
Log Water Level Measurements _____ Chemical Analysis _____ Aquifer Test _____

REMARKS:

