

STATE ENGINEER  
Salem, Oregon

LINN  
4472

# Well Record


STATE WELL NO. 10/3W-4C(1)  
COUNTY Linn  
APPLICATION NO. GR-274

OWNER: George M. & B. Caroline & Gurney B. ADDRESS: Rt. 2, Box 365  
Haworth

LOCATION OF WELL: Owner's No. 1 CITY AND STATE: Albany, Oregon

NE 1/4 NW 1/4 Sec. 4 T. 10 N. S., R. 3 W., W.M.

Bearing and distance from section or subdivision corner S. 78° 33' E. 9.912 chs. from NE cor. NW 1/4 Sec. 4

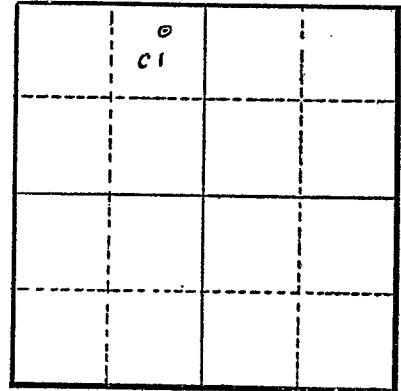

Section 4

Altitude at well 195 ft. Interpolated

TYPE OF WELL: driven Date Constructed 5/20/48

Depth drilled 25 ft. Depth cased

CASING RECORD: 4 - inch steel pipe set from 0 to 25 ft.

FINISH: Slit perforations set from 20 to 25 ft. size 1/2" x 18"

AQUIFERS: unknown

WATER LEVEL: 8 ft. below land surface

PUMPING EQUIPMENT: Type 3" Pacific centrifugal H.P. Capacity 400 G.P.M.

WELL TESTS:  
Drawdown 15 ft. after hours pumping 400 G.P.M.  
Drawdown ft. after hours G.P.M.

USE OF WATER irrigation 27.8 acres Temp. °F. 19

SOURCE OF INFORMATION Reg. St. GR-274

DRILLER or DIGGER Driven by owner

ADDITIONAL DATA:  
Log Water Level Measurements Chemical Analysis Aquifer Test

REMARKS: