

LINN
4473

Well Record

STATE WELL NO. 10/3W-4C(2)
COUNTY Linn
APPLICATION NO. GR-336

OWNER: Ruth Cobb & Elmer C. Chambers


MAILING ADDRESS: Rt. 2, Box 358

LOCATION OF WELL: Owner's No. 4

CITY AND STATE: Albany, Oregon

NE 1/4 NW 1/4 Sec. 4 T. 10 S., R. 3 W., W.M.

Bearing and distance from section or subdivision corner S. 75° W. 12 chs. from NE cor. NW 1/4 Sec. 4

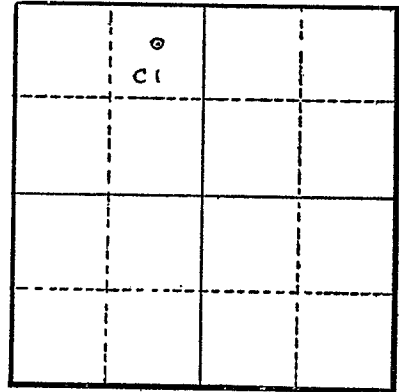

Section 4

Altitude at well 190 ft. Interpolated

TYPE OF WELL: driven Date Constructed 4/14/50

Depth drilled 25 ft. Depth cased 25 ft.

CASING RECORD: 5 - inch steel casing from 0 to 25 ft.

FINISH: Split perforations from 17 to 25 ft.

AQUIFERS: unknown

WATER LEVEL: 12 ft. below land surface

PUMPING EQUIPMENT: Type Allis Chalmers 2" centrifugal H.P. 10
Capacity 350 G.P.M.

WELL TESTS:
Drawdown 8 ft. after hours pumping 325 G.P.M.
Drawdown ft. after hours G.P.M.

USE OF WATER irrigation 27 acres Temp. °F. 19

SOURCE OF INFORMATION Reg. St. GR-336

DRILLER or DIGGER

ADDITIONAL DATA:

Log Water Level Measurements Chemical Analysis Aquifer Test

REMARKS: