

STATE ENGINEER  
Salem, Oregon

LINN  
4474

# Well Record


STATE WELL NO. 10/3W-4D  
COUNTY Linn  
APPLICATION NO. GR-3514

OWNER: Albert A. Hoefer (for F. H. Hoefer) MAILING ADDRESS: Route 2, Box 387

LOCATION OF WELL: Owner's No. Well #1 CITY AND STATE: Albany, Oregon

NW 1/4 NW 1/4 Sec. 4 T. 10 S., R. 3 W., W.M.

Bearing and distance from section or subdivision corner 445' E., 790' S.

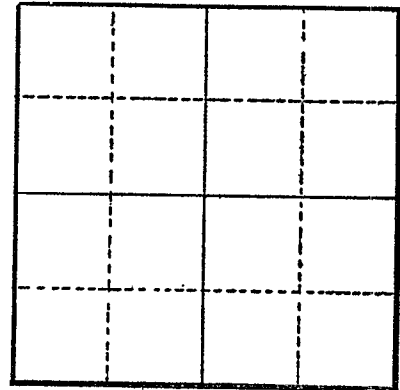

Section

Altitude at well

TYPE OF WELL: driven Date Constructed 1938

Depth drilled 21' Depth cased 21'

CASING RECORD:  
5" O.D.

### FINISH:

8 - 1/2" x 6" slots staggered from 15' to 21'

### AQUIFERS:

chehalis silt loam, gravel, sand gravel "River Boulder"

### WATER LEVEL:

10'

PUMPING EQUIPMENT: Type Allis Chalmers centrifugal H.P. 10  
Capacity 250 G.P.M.

### WELL TESTS:

Drawdown 4 ft. after hours pumping 400 G.P.M.  
Drawdown 3 ft. after hours pumping 300 G.P.M.

USE OF WATER Irrigation Temp. °F., 19

SOURCE OF INFORMATION GR-3232

DRILLER or DIGGER Albert A. Hoefer, Albany, Oregon

### ADDITIONAL DATA:

Log  Water Level Measurements  Chemical Analysis  Aquifer Test

### REMARKS:

chehalis silt-loam 10 11  
gravel-sand-"River" boulder  
mixture 11 0-?