

STATE ENGINEER
Salem, Oregon

LINN
4476


Well Record

STATE WELL NO. 10/3W-4F(1)
COUNTY Linn
APPLICATION NO. GR-274

OWNER: George M.B. & Gurney B. Haworth MAILING ADDRESS: Rt. 2, Box 365

LOCATION OF WELL: Owner's No. 2 CITY AND STATE: Albany, Oregon

SE 1/4 NW 1/4 Sec. 4 T. 10 S., R. 3 W., W.M.
Bearing and distance from section or subdivision
corner S. 18° 13' W. 29.72 chs. from NE cor. NW 1/4 Sec. 4

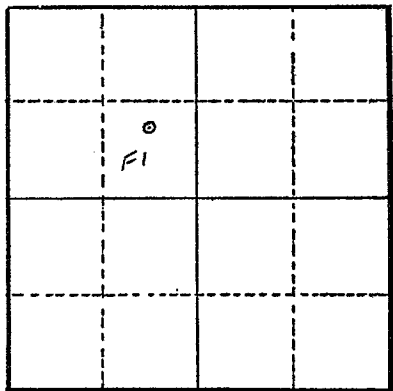

Altitude at well 190 ft. Interpolated

TYPE OF WELL: driven Date Constructed 5/25/53

Depth drilled 30 ft. Depth cased 30 ft.

Section 4

CASING RECORD: 4 - inch steel casing set from 0 to 30 ft.

FINISH: 1/2" x 18" slits set between 20 and 30 ft.

AQUIFERS: unknown

WATER LEVEL: 8 ft. below land surface

PUMPING EQUIPMENT: Type 3" Pacific centrifugal H.P. 15
Capacity 400 G.P.M.

WELL TESTS:
Drawdown 15 ft. after _____ hours pumping 400 G.P.M.
Drawdown _____ ft. after _____ hours _____ G.P.M.

USE OF WATER irrigation 28.3 acres Temp. _____ °F., 19

SOURCE OF INFORMATION Reg. St. GR-274

DRILLER or DIGGER driven well

ADDITIONAL DATA:
Log _____ Water Level Measurements _____ Chemical Analysis _____ Aquifer Test _____

REMARKS: