

STATE ENGINEER  
Salem, Oregon

LINN  
4477

# Well Record


STATE WELL NO. 10/3W-4F(2)  
COUNTY Linn  
APPLICATION NO. GR-336

OWNER: Ruth Cobb & Elmer C. Chambers  
MAILING ADDRESS: Rt. 2, Box 358

LOCATION OF WELL: Owner's No. 3  
CITY AND STATE: Albany, Oregon

SE 1/4 NW 1/4 Sec. 4 T. 10 S., R. 3 W., W.M.

Bearing and distance from section or subdivision  
corner S. 21° 25' W. 30.25 chs. from NE cor. NW 1/4  
Sec. 4

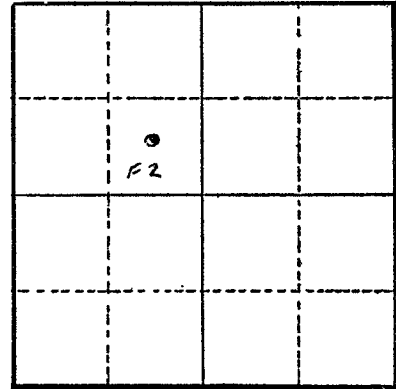

Section 4

Altitude at well 190 ft. Interpolated

TYPE OF WELL: drilled Date Constructed 4/20/50

Depth drilled 35 ft. Depth cased 32 ft.

CASING RECORD: 10 - inch casing set from 0 to 32 ft.

FINISH: Slit perforations from 24 to 32 ft.

AQUIFERS: unknwon

WATER LEVEL: 8 ft. below land surface

PUMPING EQUIPMENT: Type Allis Chalmers 2 1/2" centrifugal H.P. 15  
Capacity 450 G.P.M.

WELL TESTS:  
Drawdown 10 ft. after \_\_\_\_\_ hours pumping 500 G.P.M.  
Drawdown \_\_\_\_\_ ft. after \_\_\_\_\_ hours \_\_\_\_\_ G.P.M.

USE OF WATER irrigation 29.4 acres Temp. \_\_\_\_\_ °F. \_\_\_\_\_, 19

SOURCE OF INFORMATION Reg. St. GR-336

DRILLER or DIGGER Bill Hamilton; Albany, Oregon

ADDITIONAL DATA:  
Log \_\_\_\_\_ Water Level Measurements \_\_\_\_\_ Chemical Analysis \_\_\_\_\_ Aquifer Test \_\_\_\_\_

REMARKS: