

STATE ENGINEER
Salem, Oregon

LINN
4479

Well Record


STATE WELL NO. 10/3W-4G(1)
COUNTY Linn
APPLICATION NO. GR-75

OWNER: Carl Tonack
MAILING ADDRESS: Rt. 2, Box 366

LOCATION OF WELL: Owner's No. 2
CITY AND STATE: Albany, Oregon

SW 1/4 NE 1/4 Sec. 4 T. 10 N. S. R. 3 E. W., W.M.

Bearing and distance from section or subdivision
corner S. 17° E. 41.5 chs. from NW cor. NW 1/4 NE 1/4
Sec. 4

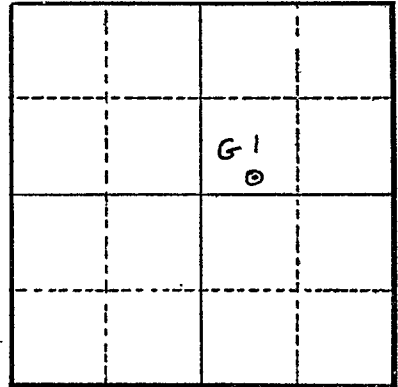

Section 4

Altitude at well 195 ft. Interpolated

TYPE OF WELL: driven Date Constructed 6/1/39

Depth drilled 24 ft. Depth cased

CASING RECORD: No casing - 24 ft.? driven well

FINISH: perforations 2" slots from 16 to 24 ft.

AQUIFERS: gravel from 20 to 24 ft.

WATER LEVEL: 10 ft. below land surface 6/10/55

PUMPING EQUIPMENT: Type 2" Pacific centrifugal H.P. 10
Capacity 210 G.P.M.

WELL TESTS:
Drawdown 14 ft. after hours 210 G.P.M.
Drawdown ft. after hours G.P.M.

USE OF WATER irrigation 21 acres Temp. °F. 19

SOURCE OF INFORMATION Reg. St. GR-75

DRILLER or DIGGER

ADDITIONAL DATA:

Log Water Level Measurements Chemical Analysis Aquifer Test

REMARKS:

