

STATE ENGINEER
Salem, Oregon

LINN
4483

Well Record

STATE WELL NO. 10/3W-4H(1)
COUNTY Linn
APPLICATION NO. GR-373


OWNER: Elton I. & Mildred Higbee &
Pauline Turnridge

MAILING ADDRESS: Rt. 2, Box 369

LOCATION OF WELL: Owner's No. 1

CITY AND STATE: Albany, Oregon

SE 1/4 NE 1/4 Sec. 4 T. 10 N. S., R. 3 W., W.M.

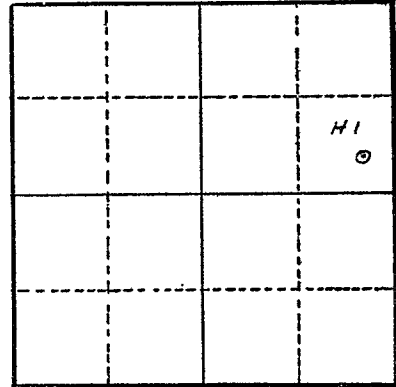

Bearing and distance from section or subdivision
corner N. 20° W. 11.8 chs. from SE 1/4 NE 1/4 Sec. 4

Section 4

Altitude at well 195 ft. Interpolated

TYPE OF WELL: drilled Date Constructed 4/10/46

Depth drilled 22 ft. Depth cased 18 ft.

CASING RECORD: 4 - inch steel casing from 0 to 18 ft.

FINISH: Slit perforations set from 13 to 18 ft.

AQUIFERS: Gravel from 10 to 22 ft.

WATER LEVEL: 10 ft. below land surface

PUMPING EQUIPMENT: Type Fairbanks Morse 2" centrifugal H.P. 10
Capacity 250 G.P.M.

WELL TESTS:
Drawdown 3 ft. after hours pumping 300 G.P.M.
Drawdown ft. after hours G.P.M.

USE OF WATER irrigation 10.5 acres Temp. °F. 19

SOURCE OF INFORMATION Reg. St. GR-373

DRILLER or DIGGER

ADDITIONAL DATA:
Log Water Level Measurements Chemical Analysis Aquifer Test

REMARKS: Log: Soil 0 to 8 ft.
Sand 8 to 10 ft.
Gravel 10 to 22 ft.