

STATE ENGINEER  
Salem, Oregon

LINN  
4486

# Well Record

STATE WELL NO. 10/3W-4I(1)  
COUNTY Linn  
APPLICATION NO. GR-1016

GR- 981

OWNER: Avery Bowen & Elton Higbee

MAILING  
ADDRESS:

Rt. 2, Box 369

LOCATION OF WELL: Owner's No. #2


CITY AND  
STATE:

Albany, Oregon

NE 1/4 SE 1/4 Sec. 4 T. 10 S. R. 3 W., W.M.

Bearing and distance from section or subdivision

corner S1°37'W. 15.71 ch. from NE cor. SE 1/4 Sec 4.

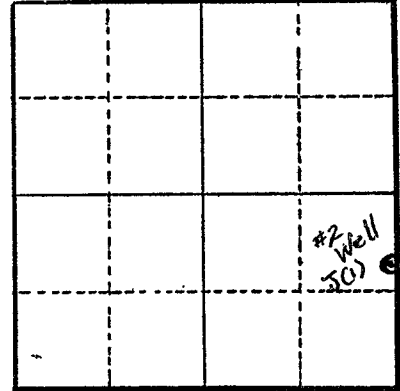

Section 4

Altitude at well 205 ft.

TYPE OF WELL: Drilled Date Constructed 1952

Depth drilled 25 ft. Depth cased 25 ft.

### CASING RECORD:

8 inch

### FINISH:

Slot perforations from 17 to 25 ft.

### AQUIFERS:

### WATER LEVEL:

9 ft.

PUMPING EQUIPMENT: Type 2" Cent.

H.P. 10

Capacity 300 G.P.M.

### WELL TESTS:

Drawdown 1 ft. after 400 hours G.P.M.

Drawdown ft. after hours G.P.M.

USE OF WATER Irrigation Temp. °F. 19

SOURCE OF INFORMATION G.R. Record

DRILLER or DIGGER Bill Hamilton Drilling Co.

### ADDITIONAL DATA:

Log N.A. Water Level Measurements Chemical Analysis Aquifer Test

### REMARKS:

Irrigation of 18.5 acres.