

STATE ENGINEER  
Salem, Oregon

LINN  
4487

# Well Record

STATE WELL NO. 10/3W-4K(1) <sup>K(2)</sup>  
COUNTY Linn  
APPLICATION NO. GR-325

OWNER: Charles & Doris Grizzel  
MAILING ADDRESS: RT. 2, Box 383

LOCATION OF WELL: Owner's No. 2 & 3  
CITY AND STATE: Albany, Oregon

N W 1/4 SE 1/4 Sec. 4 T. 10 S., R. 3 W., W.M.


Bearing and distance from section or subdivision  
corner #2 - S. 58° W. 24.5 chs. from NE cor. SE 1/4 Sec. 4

corner #3 - S. 64° W. 28.8 chs. from NE cor. SE 1/4 Sec. 4

Altitude at well 200 ft. Interpolated

TYPE OF WELL: #2 drilled #3 driven Date Constructed #2 6/5/48 #3 8/10/45

Depth drilled 24 ft. Depth cased 24 ft.

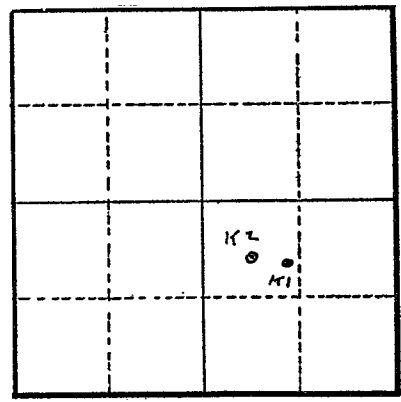

Section 4

CASING RECORD: #2 - 8 inch casing set from 0 to 24 ft.  
#3 - 8 inch casing set from 0 to 24 ft.

FINISH: #2 slit perforations set from 12 to 24 ft.  
#3 slit perforations set from 14 to 24 ft.

AQUIFERS: unknown

WATER LEVEL:

PUMPING EQUIPMENT: Type #2 - Allis Chalmers 3" centrifugal #3 - Allis Chalmers 2" centrifugal H.P. 15  
Capacity #2) 420 #3) 160 G.P.M.

WELL TESTS:  
Drawdown 1 ft. after \_\_\_\_\_ hours pumping 420 #2 G.P.M.  
Drawdown \_\_\_\_\_ ft. after \_\_\_\_\_ hours pumping 160 #3 G.P.M.

USE OF WATER irrigation 45.5 acres Temp. \_\_\_\_\_ °F. \_\_\_\_\_, 19.

SOURCE OF INFORMATION Reg. St. GR-325

DRILLER or DIGGER Bill Hamilton Well Drilling Co.; Albany, Oregon

ADDITIONAL DATA:  
Log \_\_\_\_\_ Water Level Measurements \_\_\_\_\_ Chemical Analysis \_\_\_\_\_ Aquifer Test \_\_\_\_\_

REMARKS: