

STATE ENGINEER
Salem, Oregon

LINN
4488

Well Record

STATE WELL NO. 10/3W - 4L
COUNTY LINN
APPLICATION NO. GR-2206

OWNER: George P. Nissen


MAILING ADDRESS: 185 Lake

LOCATION OF WELL: Owner's No.

CITY AND STATE: Albany, Oregon

NE 1/4 SW 1/4 Sec. 4 T. 10 N. S. R. 3 E. W., W.M.

Bearing and distance from section or subdivision corner 1656' N. and 1872' E.

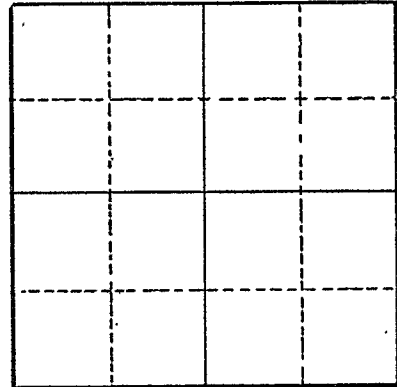

Section

Altitude at well

TYPE OF WELL: Drilled Date Constructed 1940

Depth drilled 25 Depth cased 25

CASING RECORD:

4-Inch

FINISH:

AQUIFERS:

WATER LEVEL:

PUMPING EQUIPMENT: Type Fairbanks Morse Centrifugal H.P. 10
Capacity 150 G.P.M.

WELL TESTS:

Drawdown ft. after hours G.P.M.
Drawdown ft. after hours G.P.M.

USE OF WATER Irrigation Temp. °F. 19

SOURCE OF INFORMATION GR-2111

DRILLER or DIGGER

ADDITIONAL DATA:

Log Water Level Measurements Chemical Analysis Aquifer Test

REMARKS: