

STATE ENGINEER
Salem, Oregon

LINN
4490

Well Record

STATE WELL NO. 10/3W-4N
COUNTY Linn
APPLICATION NO. GR-3858

OWNER: Vernon H. Hoefler


MAILING ADDRESS: Route 2, Box 389 B

LOCATION OF WELL: Owner's No. _____

CITY AND STATE: Albany, Oregon

SW $\frac{1}{4}$ SW $\frac{1}{4}$ Sec. 4 T. 10 N. S., R. 3 E. W., W.M.

Bearing and distance from section or subdivision corner 150' N. & 400' E. of SW cor. Sec. 4

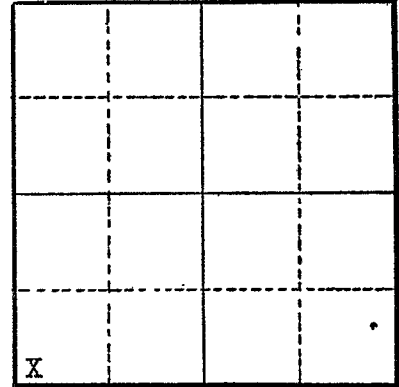

Section 4

Altitude at well _____

TYPE OF WELL: Driven Date Constructed 7/8/52

Depth drilled 30 feet Depth cased 30 feet

CASING RECORD:

5 inch casing set to 30 feet

FINISH:

three four-five inch perforations from 18" of point to 6' from point.

AQUIFERS:

WATER LEVEL:

14 feet below surface

PUMPING EQUIPMENT: Type 1" pipe Craftsman H.P. 1
Capacity 40 G.P.M.

WELL TESTS:
Drawdown 4 ft. after _____ hours 400 G.P.M.
Drawdown _____ ft. after _____ hours _____ G.P.M.

USE OF WATER Irrigation Temp. _____ °F. _____, 19

SOURCE OF INFORMATION Well Registration Statement Cert. # GR-3514

DRILLER or DIGGER Vernon H. Hoefler

ADDITIONAL DATA:

Log Water Level Measurements _____ Chemical Analysis _____ Aquifer Test _____

REMARKS:

Log: Top soil 8'; with layers of coarse sand, gravel and sand remainder 22'
large river bed type gravel 12' to 30'