

STATE ENGINEER
Salem, Oregon

LINN
4494

Well Record

STATE WELL NO. 10/3W-4R(1)
COUNTY Linn
APPLICATION NO. GR-325

OWNER: Charles & Doris Grizzel


MAILING ADDRESS: Rt. 2, Box 383

LOCATION OF WELL: Owner's No. 1

CITY AND STATE: Albany, Oregon

SE 1/4 SE 1/4 Sec. 4 T. 10 S., R. 3 W., W.M.

Bearing and distance from section or subdivision
corner N. 84° W. 19.50 chs. from SE cor. Sec. 4

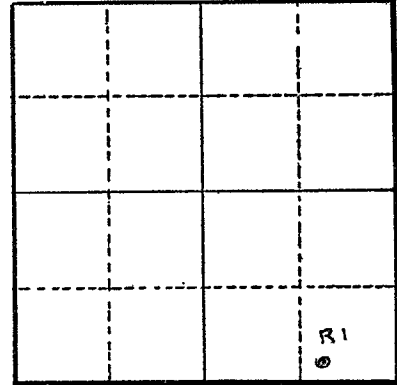

Section 4

Altitude at well 200 ft. Interpolated

TYPE OF WELL: drilled Date Constructed 4/10/45

Depth drilled 27 ft. Depth cased 27 ft.

CASING RECORD: 8 - inch steel casing set from 0 to 27 ft.

FINISH: Slit perforations from 15 to 27 ft.

AQUIFERS: unknown

WATER LEVEL:

PUMPING EQUIPMENT: Type Allis Chalmers 2" centrifugal H.P. 10
Capacity 200 G.P.M.

WELL TESTS:

Drawdown 2 ft. after _____ hours pumping 200 G.P.M.
Drawdown _____ ft. after _____ hours _____ G.P.M.

USE OF WATER irrigation 17.5 acres Temp. _____ °F. _____, 19
SOURCE OF INFORMATION Reg. St. GR-325

DRILLER or DIGGER _____

ADDITIONAL DATA:

Log _____ Water Level Measurements _____ Chemical Analysis _____ Aquifer Test _____

REMARKS: