

STATE ENGINEER
Salem, Oregon

LINN
4495

Well Record

GR- 980

STATE WELL NO. 10/3W-4R(2)
COUNTY Linn
APPLICATION NO. GR- 1015

OWNER: Avery Bowen & Elton Higbee


MAILING ADDRESS: Rt. 2, Box 369

LOCATION OF WELL: Owner's No. #1

CITY AND STATE: Albany, Oregon

SE 1/4 SE 1/4 Sec. 4 T. 10 S., R. 3 W., W.M.

Bearing and distance from section or subdivision corner N6°30'W. 12.25 ch. from SE cor. Sec. 4.

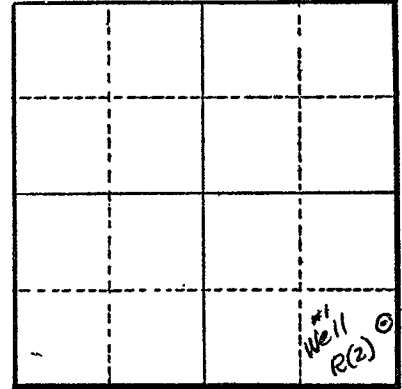

Section 4

Altitude at well 200 ft.

TYPE OF WELL: Drilled Date Constructed 1946

Depth drilled 22 ft. Depth cased 22 ft.

CASING RECORD:

5 inch

FINISH:

Slot perforations from 14 to 22 ft.

AQUIFERS:

WATER LEVEL:

4 ft.

PUMPING EQUIPMENT: Type 2/1 inch Cent. H.P. 10

Capacity 300 G.P.M.

WELL TESTS:

Drawdown 2 ft. after 300 hours G.P.M.

Drawdown ft. after hours G.P.M.

USE OF WATER Irrigation Temp. °F. 19

SOURCE OF INFORMATION G.R. Record

DRILLER or DIGGER

ADDITIONAL DATA:

Log N.A. Water Level Measurements Chemical Analysis Aquifer Test

REMARKS:

Irrigation of 9.5 acres.