

STATE ENGINEER
Salem, Oregon

LINN
4512

Well Record

GR- 1613

STATE WELL NO. 10/3W-5A
COUNTY Linn
APPLICATION NO. GR- 1662

OWNER: J. P. Grizzel


MAILING ADDRESS: Rt. 2, Box 361

LOCATION OF WELL: Owner's No. #1

CITY AND STATE: Albany, Oregon

NE 1/4 NE 1/4 Sec. 5 T. 10 S., R. 3 W., W.M.

Bearing and distance from section or subdivision corner 22.5 ch. S. 48° 20' W. from NE cor. Sec. 5

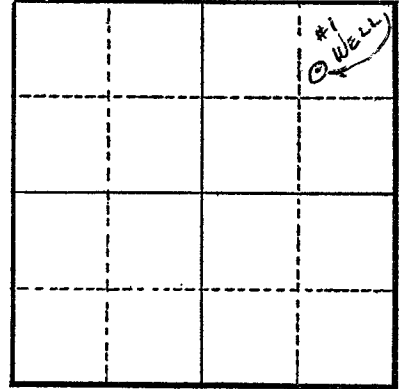

Section 5

Altitude at well 190'

TYPE OF WELL: Driven Date Constructed 1950

Depth drilled 26' Depth cased 26'

CASING RECORD:

4"

FINISH:

Slot perforations from 22 to 26 ft.

AQUIFERS:

WATER LEVEL:

8'

PUMPING EQUIPMENT: Type A. C. 3" Cent. H.P. 15
Capacity 350 G.P.M.

WELL TESTS:

Drawdown _____ ft. after _____ hours _____ G.P.M.
Drawdown _____ ft. after _____ hours _____ G.P.M.

USE OF WATER Irrigation Temp. _____ °F. _____, 19

SOURCE OF INFORMATION GR Record

DRILLER or DIGGER Jasper Turnidge & Lynn Hofer

ADDITIONAL DATA:

Log N.A. Water Level Measurements _____ Chemical Analysis _____ Aquifer Test _____

REMARKS:

Irrigation of 17.4 acres.