

STATE ENGINEER
Salem, Oregon

LINN
4514

Well Record

STATE WELL NO. 10/3W-5A(1)
COUNTY Linn
APPLICATION NO. GR-173

OWNER: Myron & Ballard Ingraham


MAILING ADDRESS: Rt. 2, Box 362

LOCATION OF WELL: Owner's No. 3

CITY AND STATE: Albany, Oregon

NE 1/4 NE 1/4 Sec. 5 T. 10 S., R. 3 W., W.M.

Bearing and distance from section or subdivision corner S. 9.1 chs. from NE cor. Sec. 5

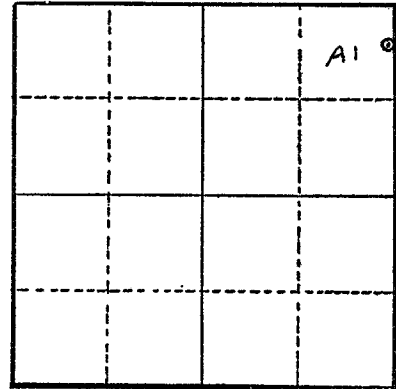

Section 5

Altitude at well 190 ft. Interpolated

TYPE OF WELL: drilled Date Constructed 4/6/53

Depth drilled 25 ft. Depth cased 25 ft.

CASING RECORD: 4 - inch steel casing from 0 to 25 ft.

FINISH: Slit perforations set from 15 to 25 ft.

AQUIFERS: unknown

WATER LEVEL: unknown

PUMPING EQUIPMENT: Type 2 " Pacific centrifugal H.P. 10

Capacity 250 G.P.M.

WELL TESTS:

Drawdown 3 ft. after hours pumping 300 G.P.M.

Drawdown ft. after hours G.P.M.

USE OF WATER irrigation 18.5 acres Temp. °F. 19

SOURCE OF INFORMATION Reg. St. GR-173

DRILLER or DIGGER T.J. Burkhardt; 169 N. 1st, W. Tremonton, Utah

ADDITIONAL DATA:

Log Water Level Measurements Chemical Analysis Aquifer Test

REMARKS: