

STATE ENGINEER
Salem, Oregon

LINN
4516

Well Record

GR- 1398

STATE WELL NO. 10/3W-5B
COUNTY Linn
APPLICATION NO. GR- 1451

OWNER: L. Charles & Alice Henion


MAILING ADDRESS: Rt. 2, Box 359

LOCATION OF WELL: Owner's No. #2

CITY AND STATE: Albany, Oregon

NW 1/4 NE 1/4 Sec. 5 T. 10 S., R. 3 W., W.M.

Bearing and distance from section or subdivision corner S. 18° 30' E. 19.5 ch. from N¹ cor. Sec. 5

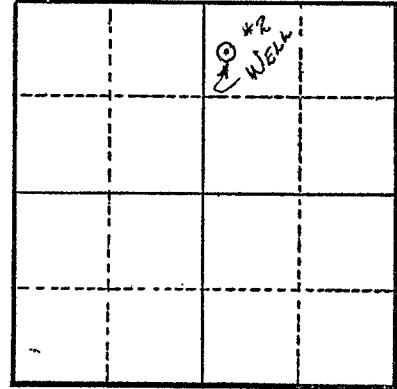

Section 5

Altitude at well 190'

TYPE OF WELL: Driven Date Constructed 1944

Depth drilled 25' Depth cased 25'

CASING RECORD:

4"

FINISH:

Slot perforated from 19' to 25'

AQUIFERS:

WATER LEVEL:

14'

PUMPING EQUIPMENT: Type F. M. 2" Cent. H.P. 10
Capacity 250 G.P.M.

WELL TESTS:

Drawdown 6 ft. after _____ hours 250 G.P.M.

Drawdown _____ ft. after _____ hours _____ G.P.M.

USE OF WATER Irrigation Temp. _____ °F. _____, 19

SOURCE OF INFORMATION GR Record

DRILLER or DIGGER D. L. Cook

ADDITIONAL DATA:

Log N.A. Water Level Measurements _____ Chemical Analysis _____ Aquifer Test _____

REMARKS:

Irrigation of 17.3 acres.