

STATE ENGINEER
Salem, Oregon

LINA
4521

Well Record

GR- 1399

STATE WELL NO. 10/3W-5G
COUNTY Linn
APPLICATION NO. GR- 1452

OWNER: L. Charles & Alice Henion


MAILING ADDRESS: Rt. 2, Box 359

LOCATION OF WELL: Owner's No. #3

CITY AND STATE: Albany, Oregon

SW 1/4 NE 1/4 Sec. 5 T. 10 S., R. 3 W., W.M.

Bearing and distance from section or subdivision corner N.84°W. 34.5 ch. from E¹ cor. Sec. 5

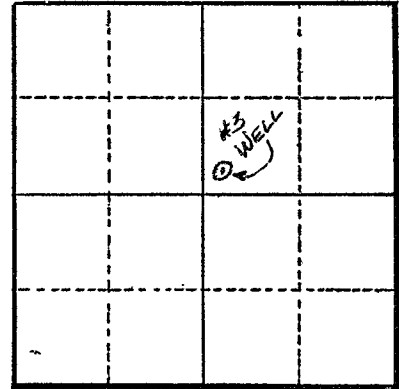

Section 5

Altitude at well 190'

TYPE OF WELL: Driven Date Constructed 1943

Depth drilled 27' Depth cased 27'

CASING RECORD:

4"

FINISH:

Slot perforations from 21' to 27'

AQUIFERS:

WATER LEVEL:

13'

PUMPING EQUIPMENT: Type F. M. 2" Cent. H.P. 10

Capacity 250 G.P.M.

WELL TESTS:

Drawdown 5 ft. after 250 hours G.P.M.

Drawdown _____ ft. after _____ hours G.P.M.

USE OF WATER Irrigation Temp. _____ °F., 19

SOURCE OF INFORMATION GR Record

DRILLER or DIGGER D. L. Cook

ADDITIONAL DATA:

Log N.A. Water Level Measurements _____ Chemical Analysis _____ Aquifer Test _____

REMARKS:

Irrigation of 28.1 acres.